



**Sidewalk Detour or Diversion (TA-28)
The City Church
4100 River Road NW**

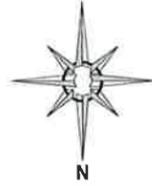


SCOPE OF WORK: THE PURPOSE OF THIS PROJECT IS TO REPAIR/REPLACE BOLLARDS ON THE CORNER OF RIVER ROAD & MURDOCK MILL ROAD NW. ACCESS TO ALLEYWAY WILL BE PROVIDED DURING THE PROJECT. THE LENGTH OF TIME FOR THE PROJECT SHALL BE 1-2 DAYS.

Legend Work Area

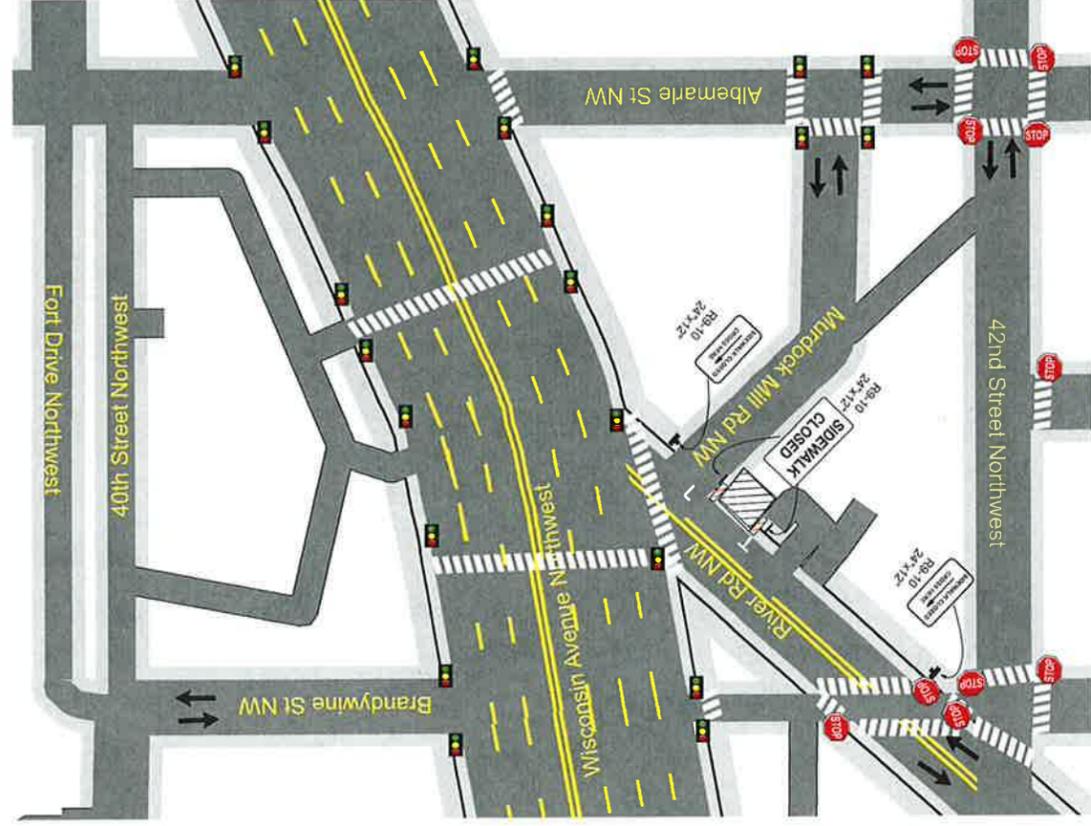

SPEED (MPH)	(ft)
25	150
30	200
35	250
40	350
45	550
50	600
55	700

GENERAL NOTES:
- PARKING IS TO BE RESTRICTED 72 HOURS IN ADVANCE UNLESS THERE IS AN EMERGENCY.
- SIGNS SHALL BE INSTALLED PRIOR TO THE COMMENCEMENT OF ALL WORK AND REMOVED IMMEDIATELY AFTER COMPLETION OF ACTIVITIES.
- IF A SIGN IS NO LONGER REQUIRED, IT WILL BE REMOVED.
- SIGNS SHALL BE MOUNTED ON SPRING LOADED STANDS.
- THE SPACING OF TRAFFIC CONES IS TO BE 10 FT.
- IN CASE OF ONE-WAY ROADWAY, CONE OPPOSITE SIGNS HAVE APPROACHING WORK AHEAD.
- IF A BUS ROUTE TRAVEL LANE MUST BE MINIMUM 11 FT. IN WIDTH, OTHERWISE LANE SHOULD BE 10 FT PERMIT EXPRESS IS NOT RESPONSIBLE FOR THIS TCP IS FOR PERMIT PURPOSES ONLY.

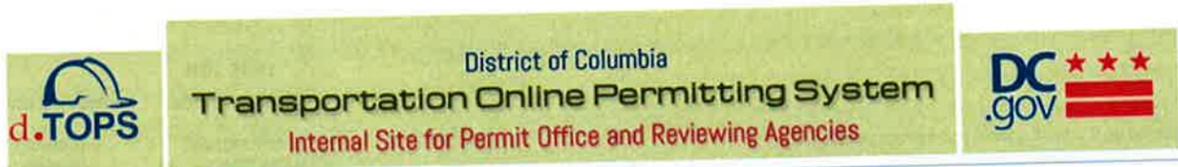

Home Plan Review PSRA review Tree Permit Review and Inspection Notice of Violation Manage Reviewer Company Registration Report Others Recent Places Sign-out

Welcome **Catrina Felder**
 You are logged in as **PSRA Manager, Public Space Regulations Administration**

Permit Details

[Back to Previous Page](#)

This is NOT a PERMIT

Tracking Number: 157657
 Intake Date: 05/15/2016
 Assigned Date: 05/18/2016
 Assigned Technician: Catrina Felder
 Permit Type:
 Archived?: **N**
 Status: **Assigned**
 Work Location: [4100 RIVER ROAD NW, WASHINGTON, DC 20016](#) [View Map](#)
 Locked? **N**
 Effective Date: 06/06/2016
 Type Description: Fixture: Bollard(s) (Exception)
 Work Detail: Replace one Bollard and install an additions Bollard, totaling two Bollards
 Conditions:
 *All street trees located within the work zone shall have a 6' high chain link fence placed around the tree space to the extent of the box (min 4' x 9') or in a continuous planting space to the extent of the dripline. The fence shall be installed prior to work starting and removed after work has been completed.
 *All work must comply with all District regulations and statutes. Violation may result in revocation of this permit.
 *Extended restoration may be required. Level of restoration to be determined by DDOT. A DDOT Public Space Construction Inspector (202-645-7050) must authorize any restoration before work begins.
 *Must follow approved site plan without deviation.
 *No work in public space permitted during official DC government holidays.
 *Permit holder is responsible for all damage to public space as a result of work done under this permit.
 *Permit holder responsible for obtaining any additional permits required by statute or regulation including DOH, DDOE and DCRA permits.
 *Person who posts an unauthorized sign or removes an authorized sign is subject to a fine of \$100 per day.
 *Renewals require all prior public space permits be on premise.
 *Speeding violation fines are doubled in construction work zones.
 *This construction permit requires a separate valid permit for temporary occupancy to be on site during the time work is being performed.
 *This permit does not authorize the posting of No Parking signs. A separate public space occupancy permit is required.
 *This permit is not valid until the later of the Effective Date and the Issuance Date.
 *This permit is revocable at any time at the discretion of FEMS, MPD and/or DDOT
 *This permit must be on site at all times and visible from public space.
 *Work hours in public space are listed on the approved Traffic Control Plan. Any work in public space before 7am or after 7pm Mon. thru Sat. or all day Sun. requires an additional permit from DCRA.

Business Name: THE CITY CHURCH
 Applicant Name: Paul Tarr [5 other recent applications by this applicant](#)
 Permit Fee (include Technology Fee): \$297.00
 Last Updated By: DeAngelo Baynes
 Owner Name: The City Church

Permit Number:
 Intake Technician:
 Assigned Manager:
 Assigned Inspector: Mildred/Nicole Summers
 Renewal: **New**
 Legacy?: **N**
 Source Permit:
 Issue Date:
 Expiration Date: 06/08/2016
 EWR #:
 Business Owner Name:
 Permit Tech:
 Permit Fees Payment Date:
 Last Updated Date: 05/31/2016
 Owner Address: 4100 River Road NW, Washington, DC 20016

6/28/2016 9:34 AM

Agency	Sent Date	Return Date	Reviewer Name	Status	Util #	Notes
WMATA/JDAC	05/31/2016		LaShawn Bost	NO RESPONSE	61460	
VERIZON	05/31/2016	06/02/2016	Mary Polk	APPROVED	61461	
OP	05/31/2016	06/20/2016	Timothy Maher	REVISION NEEDED		Jun 20 2016 10:59AM tmaher wrote for Applicant - - OP can support the bollard installed at the rear of the sidewalk adjacent to the alley as a form of pedestrian protection. However, OP does not support the installation of a new bollard out by the established curbline of River Road.
UFA	05/31/2016	06/16/2016	Sharon Dendy	REVIEW NOT REQUIRED		Jun 16 2016 4:55PM sdendy wrote for Applicant - UFA defers to DDOT PPSA and the Office of Planning with regards to the bollard installation since there are no existing street trees and the mulched strip in front of the property is less than 4 feet and does not contain any other plant materials.
WASH GAS	05/31/2016	06/20/2016	Don Srisukwattananan	APPROVED WITH CONDITION	61462	Jun 20 2016 4:14PM dsrisukwattan wrote for Applicant - There is an active 4" gas main around the proposed bollard location. Call Miss Utility before digging.
Single Members District	05/31/2016		SELECT MEMBER	NO RESPONSE		
CashManager	05/31/2016		Tiffany Tenbrook	NO RESPONSE		
ANC			ANC 3E	NOT SENT	N/A	


[Download All Files as Zip](#)

Document Name	Status	Size(kb)	Uploaded By	Date Uploaded	View
Document Group: Photos					
157657_PHOTOS_811923_20160516_062516(Medium).tif	Submitted Online	740	Paul Tarr	5/16/2016	No Markups
157657_PHOTOS_814547_20160516_062516(Medium).tif	Submitted Online	740	Paul Tarr	5/16/2016	No Markups
157657_PHOTOS_559677_20160516_062617(Medium).tif	Submitted Online	688	Paul Tarr	5/16/2016	No Markups
157657_PHOTOS_603325_picofbollardsite(Medium).tif	Submitted Online	886	Paul Tarr	5/16/2016	No Markups
157657_PHOTOS_934230_20160516_062554(Medium).tif	Submitted Online	781	Paul Tarr	5/16/2016	No Markups
157657_PHOTOS_973515_20160516_062548(Medium).tif	Submitted Online	747	Paul Tarr	5/16/2016	No Markups
157657_PHOTOS_307335_TheCityChurchSitePlan.pdf	Submitted Online	309	Paul Tarr	5/16/2016	No Markups
157657_PHOTOS_112185_TCP-4100RiverRdNW.pdf	Submitted Online	570	Paul Tarr	5/17/2016	No Markups
157657_PHOTOS_196335_ShopDrawing.pdf	Submitted Online	231	Paul Tarr	5/19/2016	No Markups
157657_PHOTOS_104327_TheCityChurchSitePlan-BollardLocations.pdf	Submitted Online	310	Paul Tarr	5/19/2016	No Markups

Selected Type Descriptives:

Type Descriptives	Dimension Details
Type Descriptive Group: Fixture	
Bollard(s) (Exception)	2 (Quantity)

[Back to Previous Page](#)

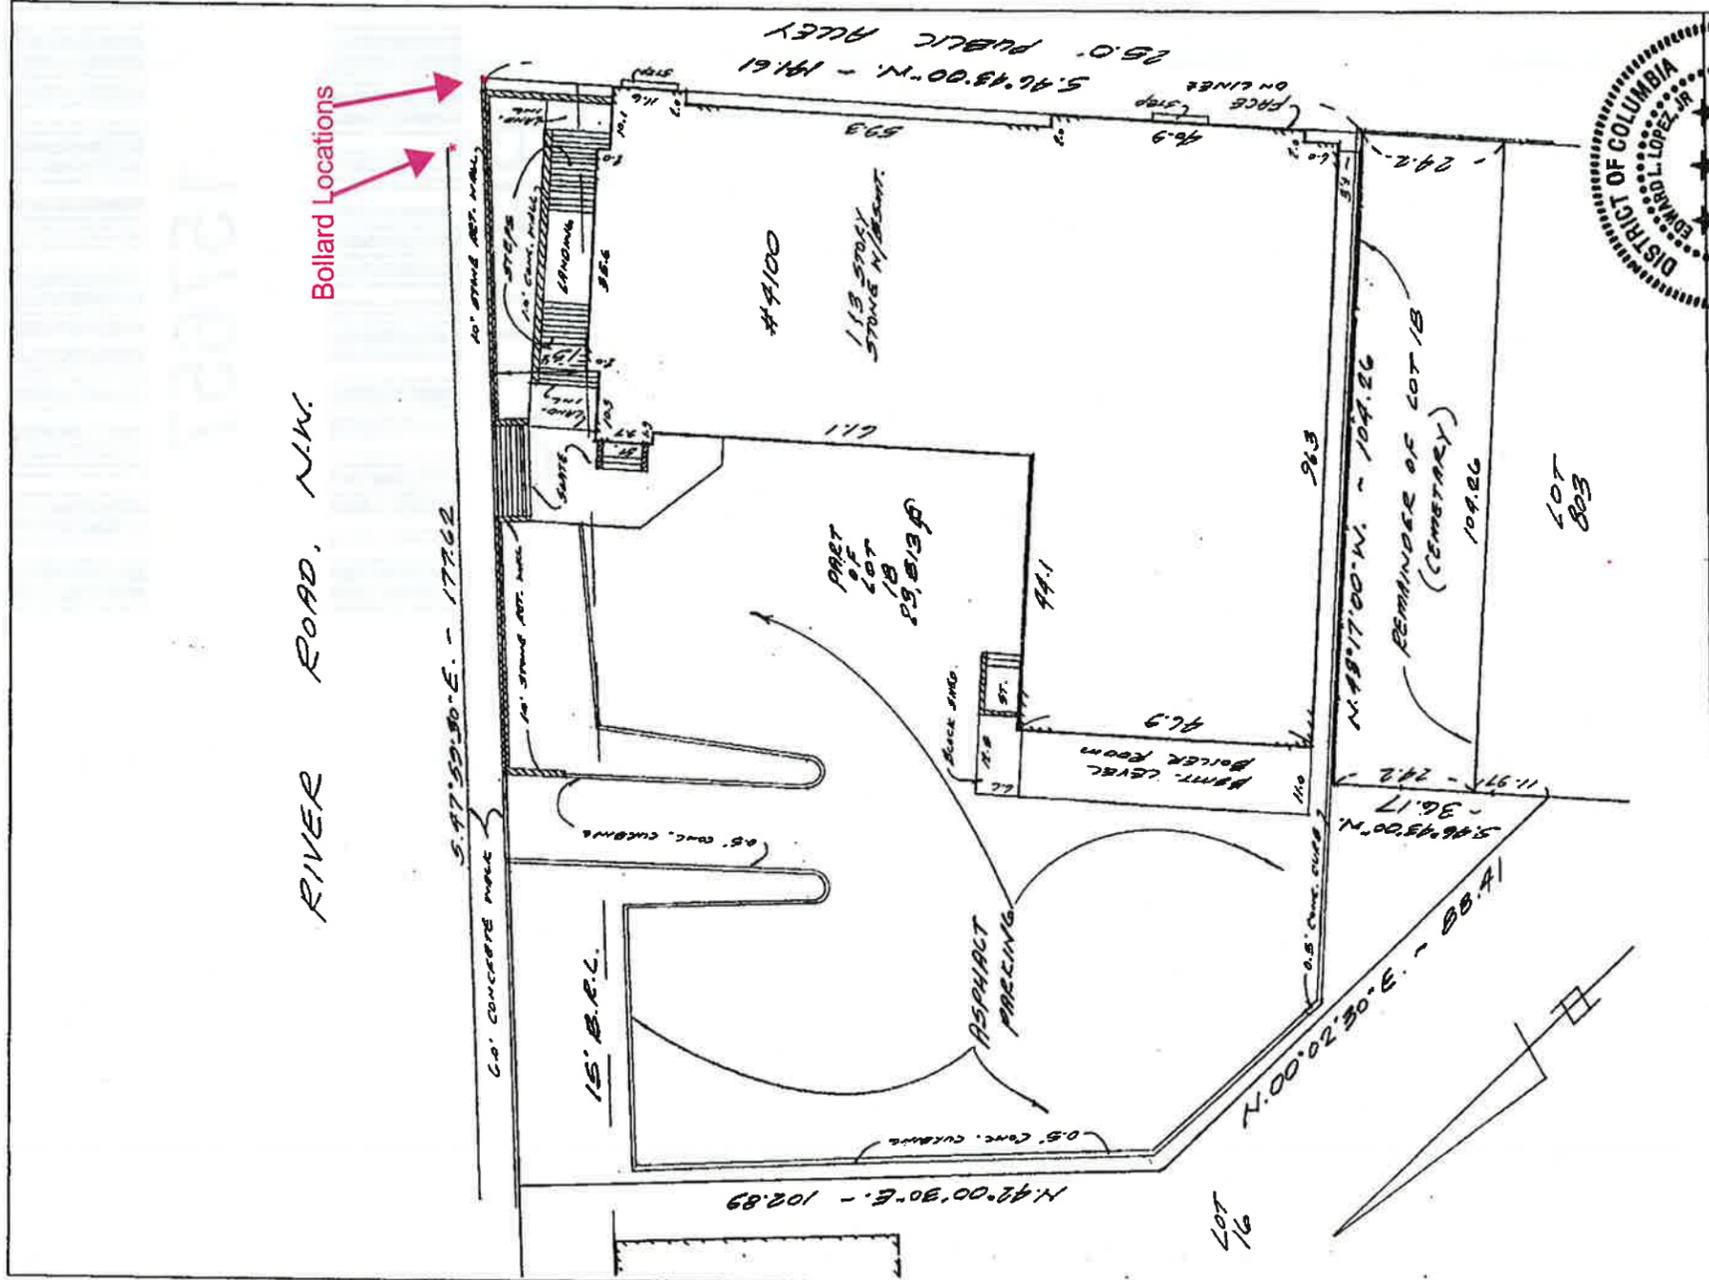

Bollard Locations

10762 Rhode Island Avenue
Beltsville, MD 20705

Capitol Surveys, Inc.

NOTE: This drawing is not intended to establish property lines. It cannot be used for construction or design purposes. All information shown hereon taken from the land records of the county or city in which the property is located and field work performed. This survey prepared for this purposes only.
© As of current date.

DATE: NOV. 2, 2007

Case: 0705019

Recorded in Liber ~ 202

File: 87211

Scale 1" = 20'

Part of Lot 18

Location Drawing Square - 1730

Lot 18 DISTRICT OF COLUMBIA

Recorded in Liber ~ 202

File: 105

Scale 1" = 20'

Case: 0705019

File: 87211

DISTRICT OF COLUMBIA
EDWARD L. LOPEZ, JR.
No. LS900239

EDWARD L. LOPEZ, JR.
D.C. Licensed Land Surveyor

Phone: 301-931-3550
Fax: 301-931-3552

1500 Certified Professional Surveyor
I have certified this drawing to be the original and true copy of the above established survey, and I have been established for the District of Columbia, and that unless otherwise stated, there are no visible encroachments.

Capitol Surveys, Inc.

10762 Rhode Island Avenue
Beltsville, Maryland 20705
Phone 301-931-1350
Fax 301-931-1352

November 2, 2007

**Metes and Bounds Description for cemetery conveyance from
Lot 18, Square 1730**

Case: 0705019


File: 87211

Being Part of Lot 18, Square 1730, said Lot 18 being recorded in the Office of the Surveyor of the District of Columbia in Subdivision Book 202 at page 105, said part being more particularly described as follows:

Beginning at the most Southerly corner of Lot 18, Square 1730, said corner being on the Northerly right of way line of a 25.0 foot public alley, thence

1. N. 43° 17' 00" W., 104.26 feet to a point, thence
2. N. 46° 43' 00" E., 24.20 feet to a point, thence
3. S. 43° 17' 00" E., 104.26 feet to a point on aforementioned public alley, thence
4. S. 46° 43' 00" W., 24.20 feet along said alley to the point or place of beginning and containing 2523.0 square feet of land, more or less.

THE CITY CHURCH - 4100 RIVER RD NW, WASHINGTON DC
 NEW VEHICLE SAFETY BOUNDS - SCALE: N.T.S.

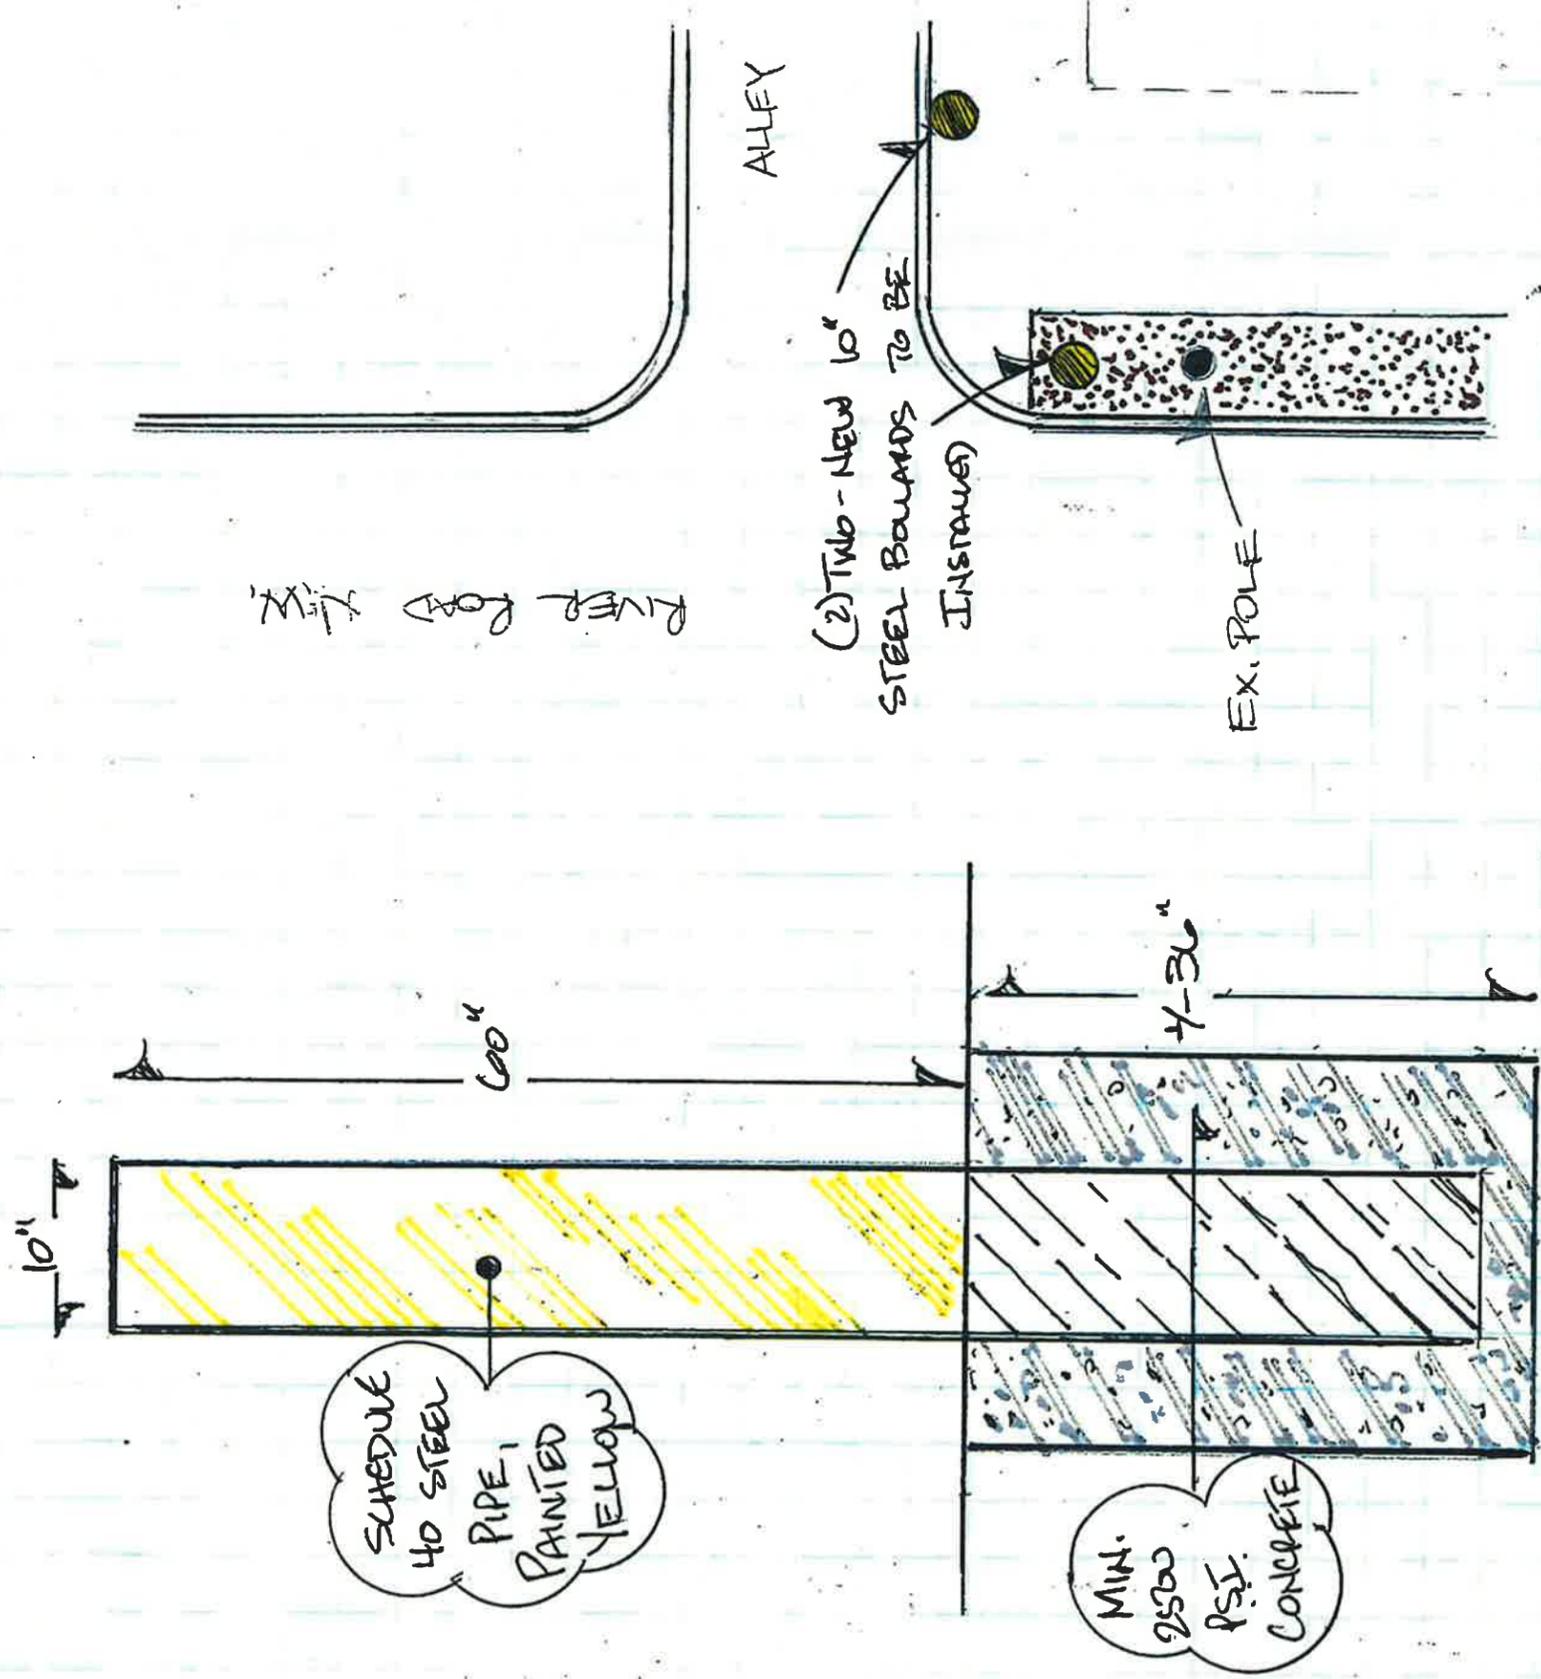

BOUND ELEVATION VIEW

BOUND LOCATIONS

PREPARED BY: MARK MAUSTER
 CONTRACTOR: HERCULES FENCE
 DATE: 5/14/16